


**BUILDING PERMIT APPLICATION PLAN  
LAND OF JANE BEAL-COSTELLO  
307 PORTSMOUTH AVENUE  
SEABROOK, NH**


**SCALE: 1"=20' APRIL 18, 2010**

STOCKTON SERVICES  
PO BOX 1306, HAMPTON, NH 03843-1306  
603 929-7404

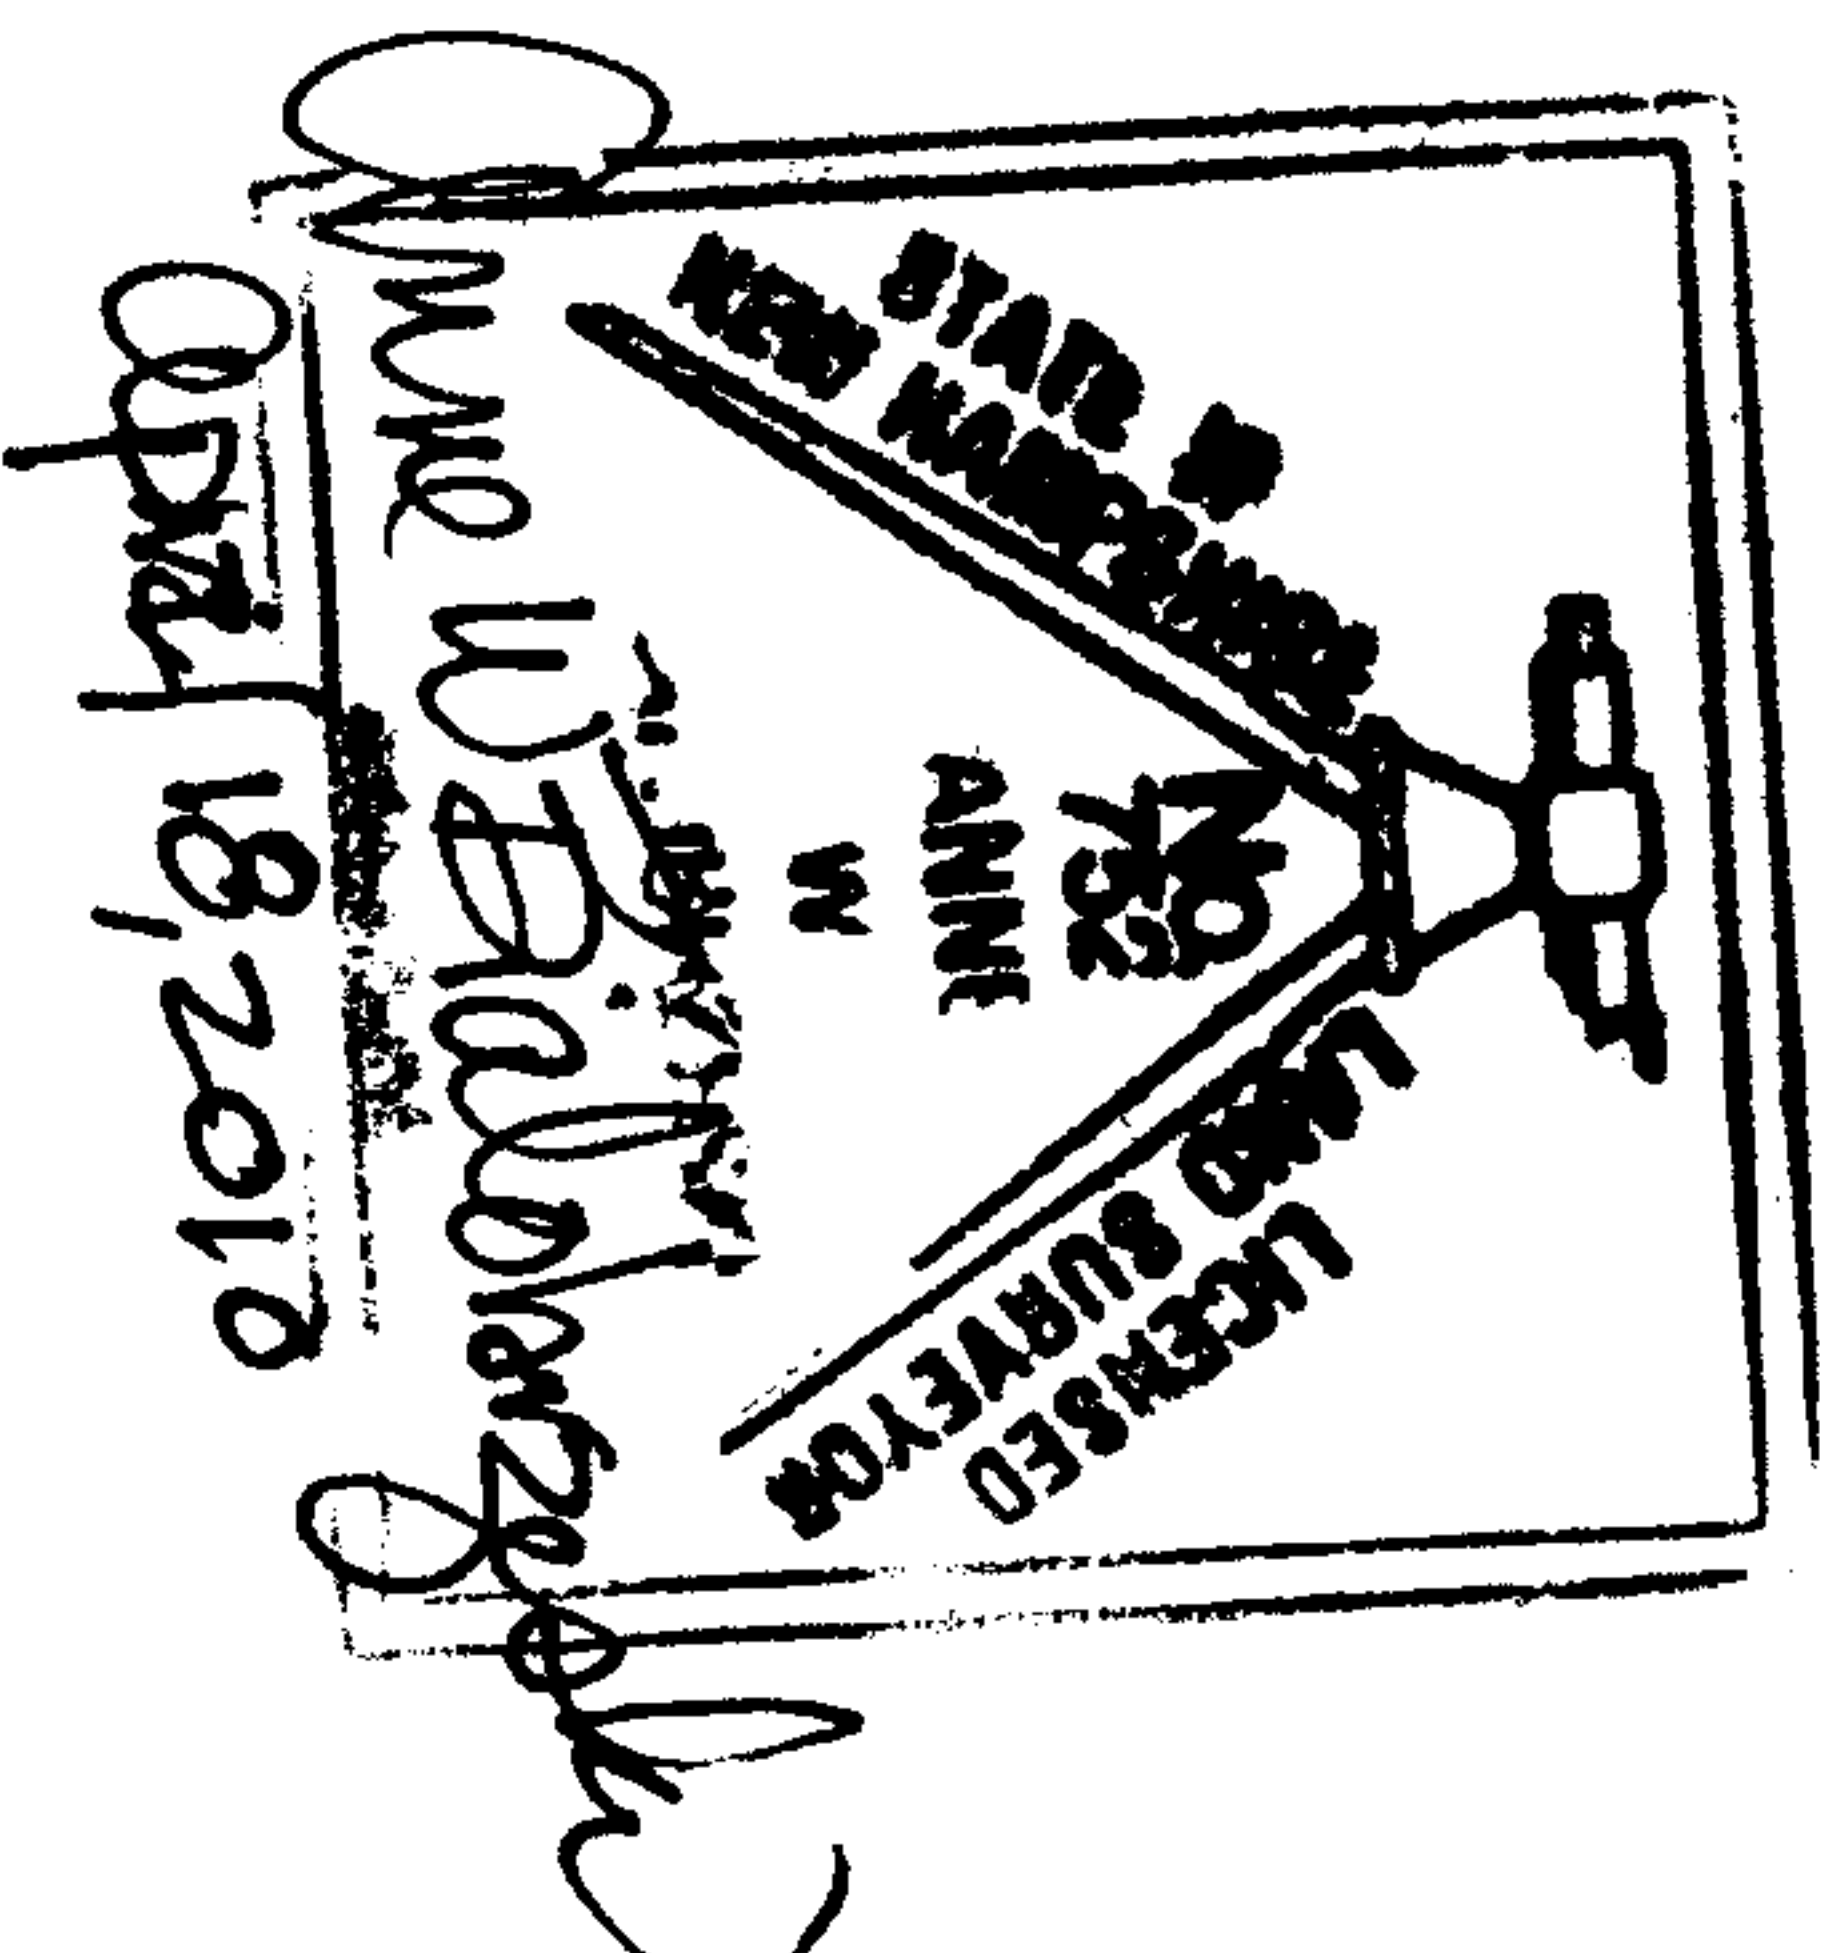


THE PURPOSE OF THIS PLAN IS TO SHOW  
PROPOSED BUILDING AND SETBACKS FOR  
BUILDING PERMIT APPLICATION ONLY.  
NO OTHER REPRESENTATION IS INTENDED  
OR IMPLIED.

NOTE:  
BUILDING SETBACKS SHOWN  
ARE TO ROOF OVERHANG.

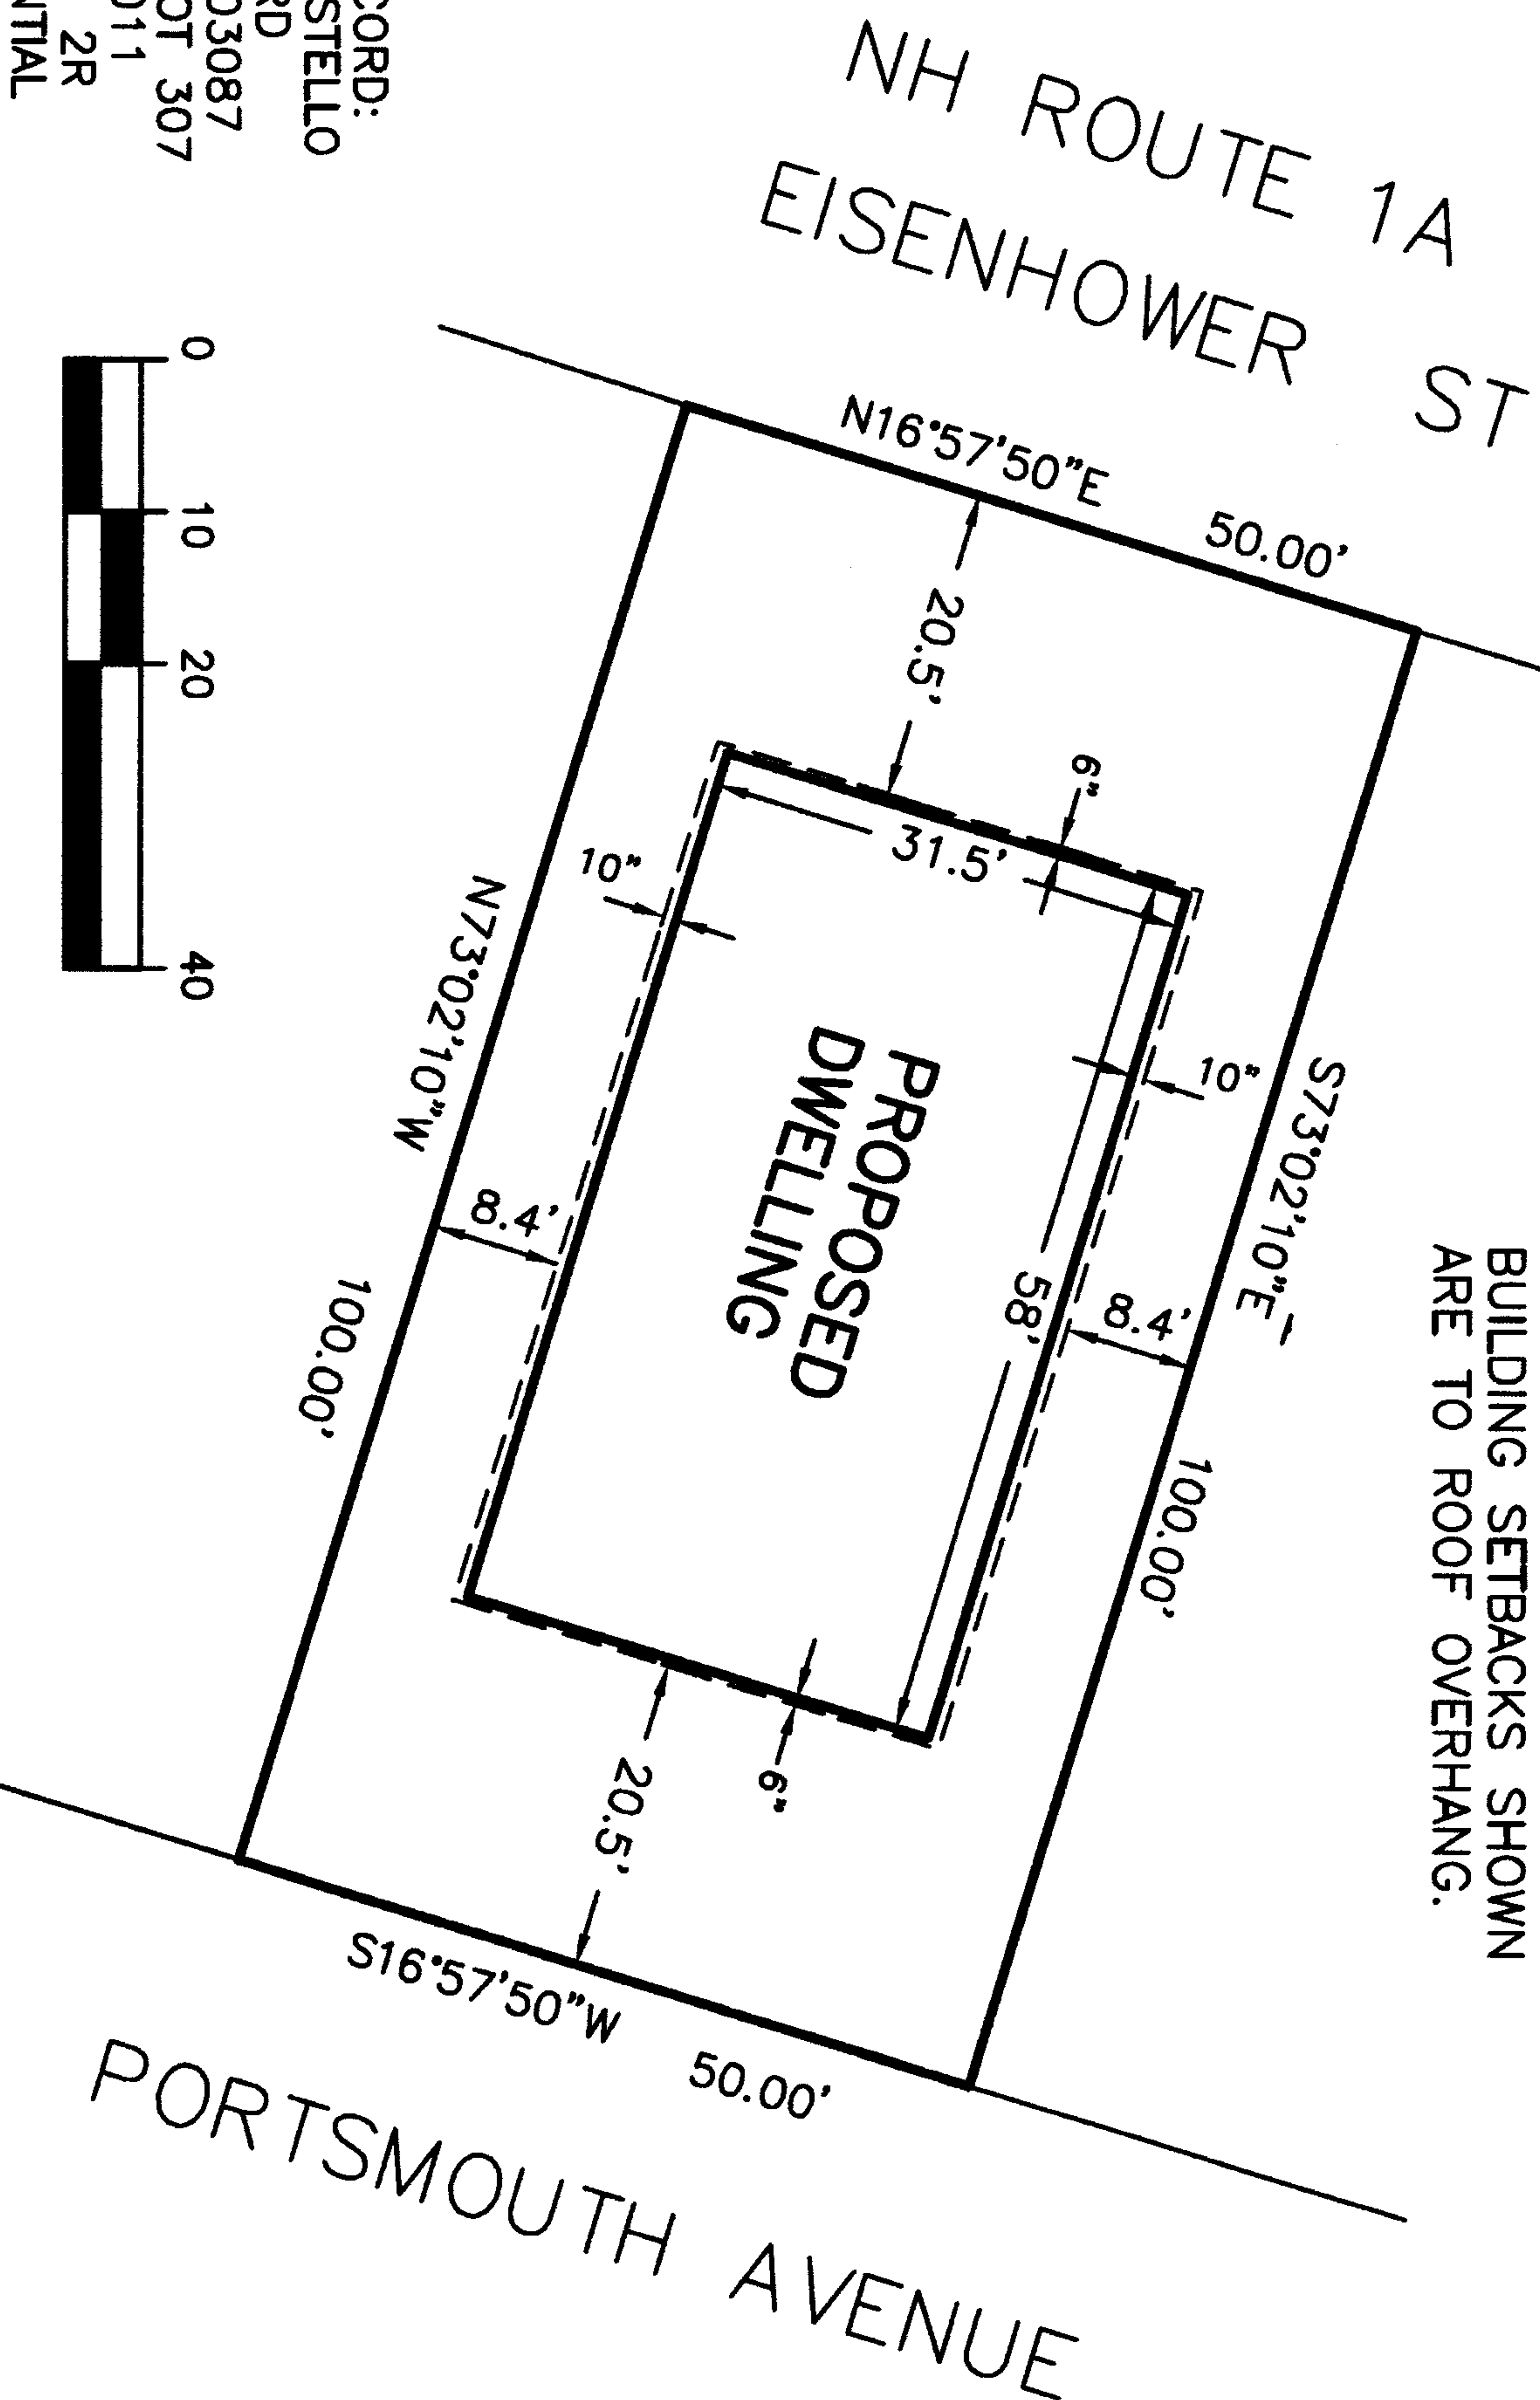

OWNER OF RECORD:  
JANE BEAL-COSTELLO  
28 FARWOOD RD  
WINDHAM, NH 03087  
TAX MAP 20 LOT 307  
RCRD 4226-1011  
ZONING CLASS: 2R  
BEACH RESIDENTIAL

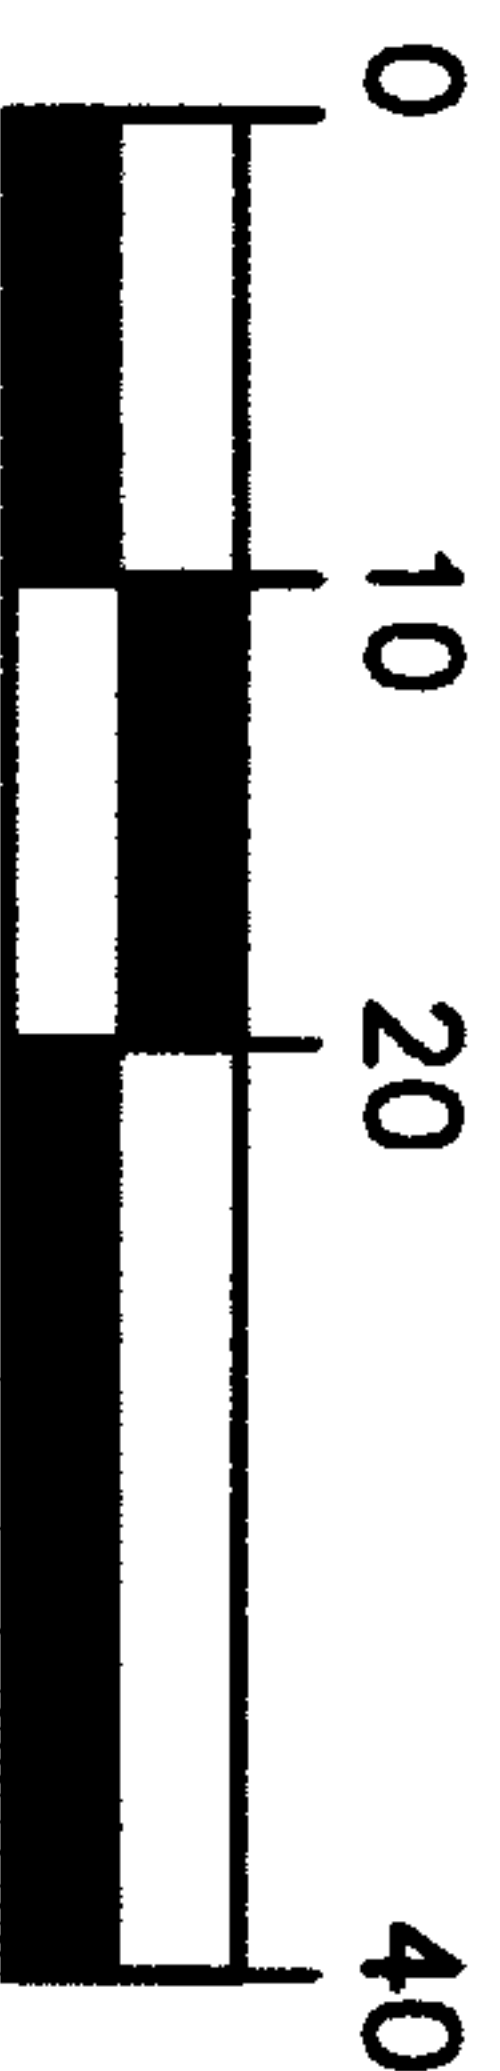


**BUILDING PERMIT APPLICATION PLAN  
LAND OF JANE BEAL-COSTELLO  
307 PORTSMOUTH AVENUE  
SEABROOK, NH**

**SCALE: 1"=20' APRIL 20, 2010**



STOCKTON SERVICES  
PO BOX 1306, HAMPTON, NH 03843-1306  
603 929-7404

OWNER OF RECORD:  
JANE BEAL-COSTELLO  
28 FARWOOD RD  
WINDHAM, NH 03087  
TAX MAP 20 LOT 307  
RCRD 4226-1011  
ZONING CLASS: 2R  
BEACH RESIDENTIAL

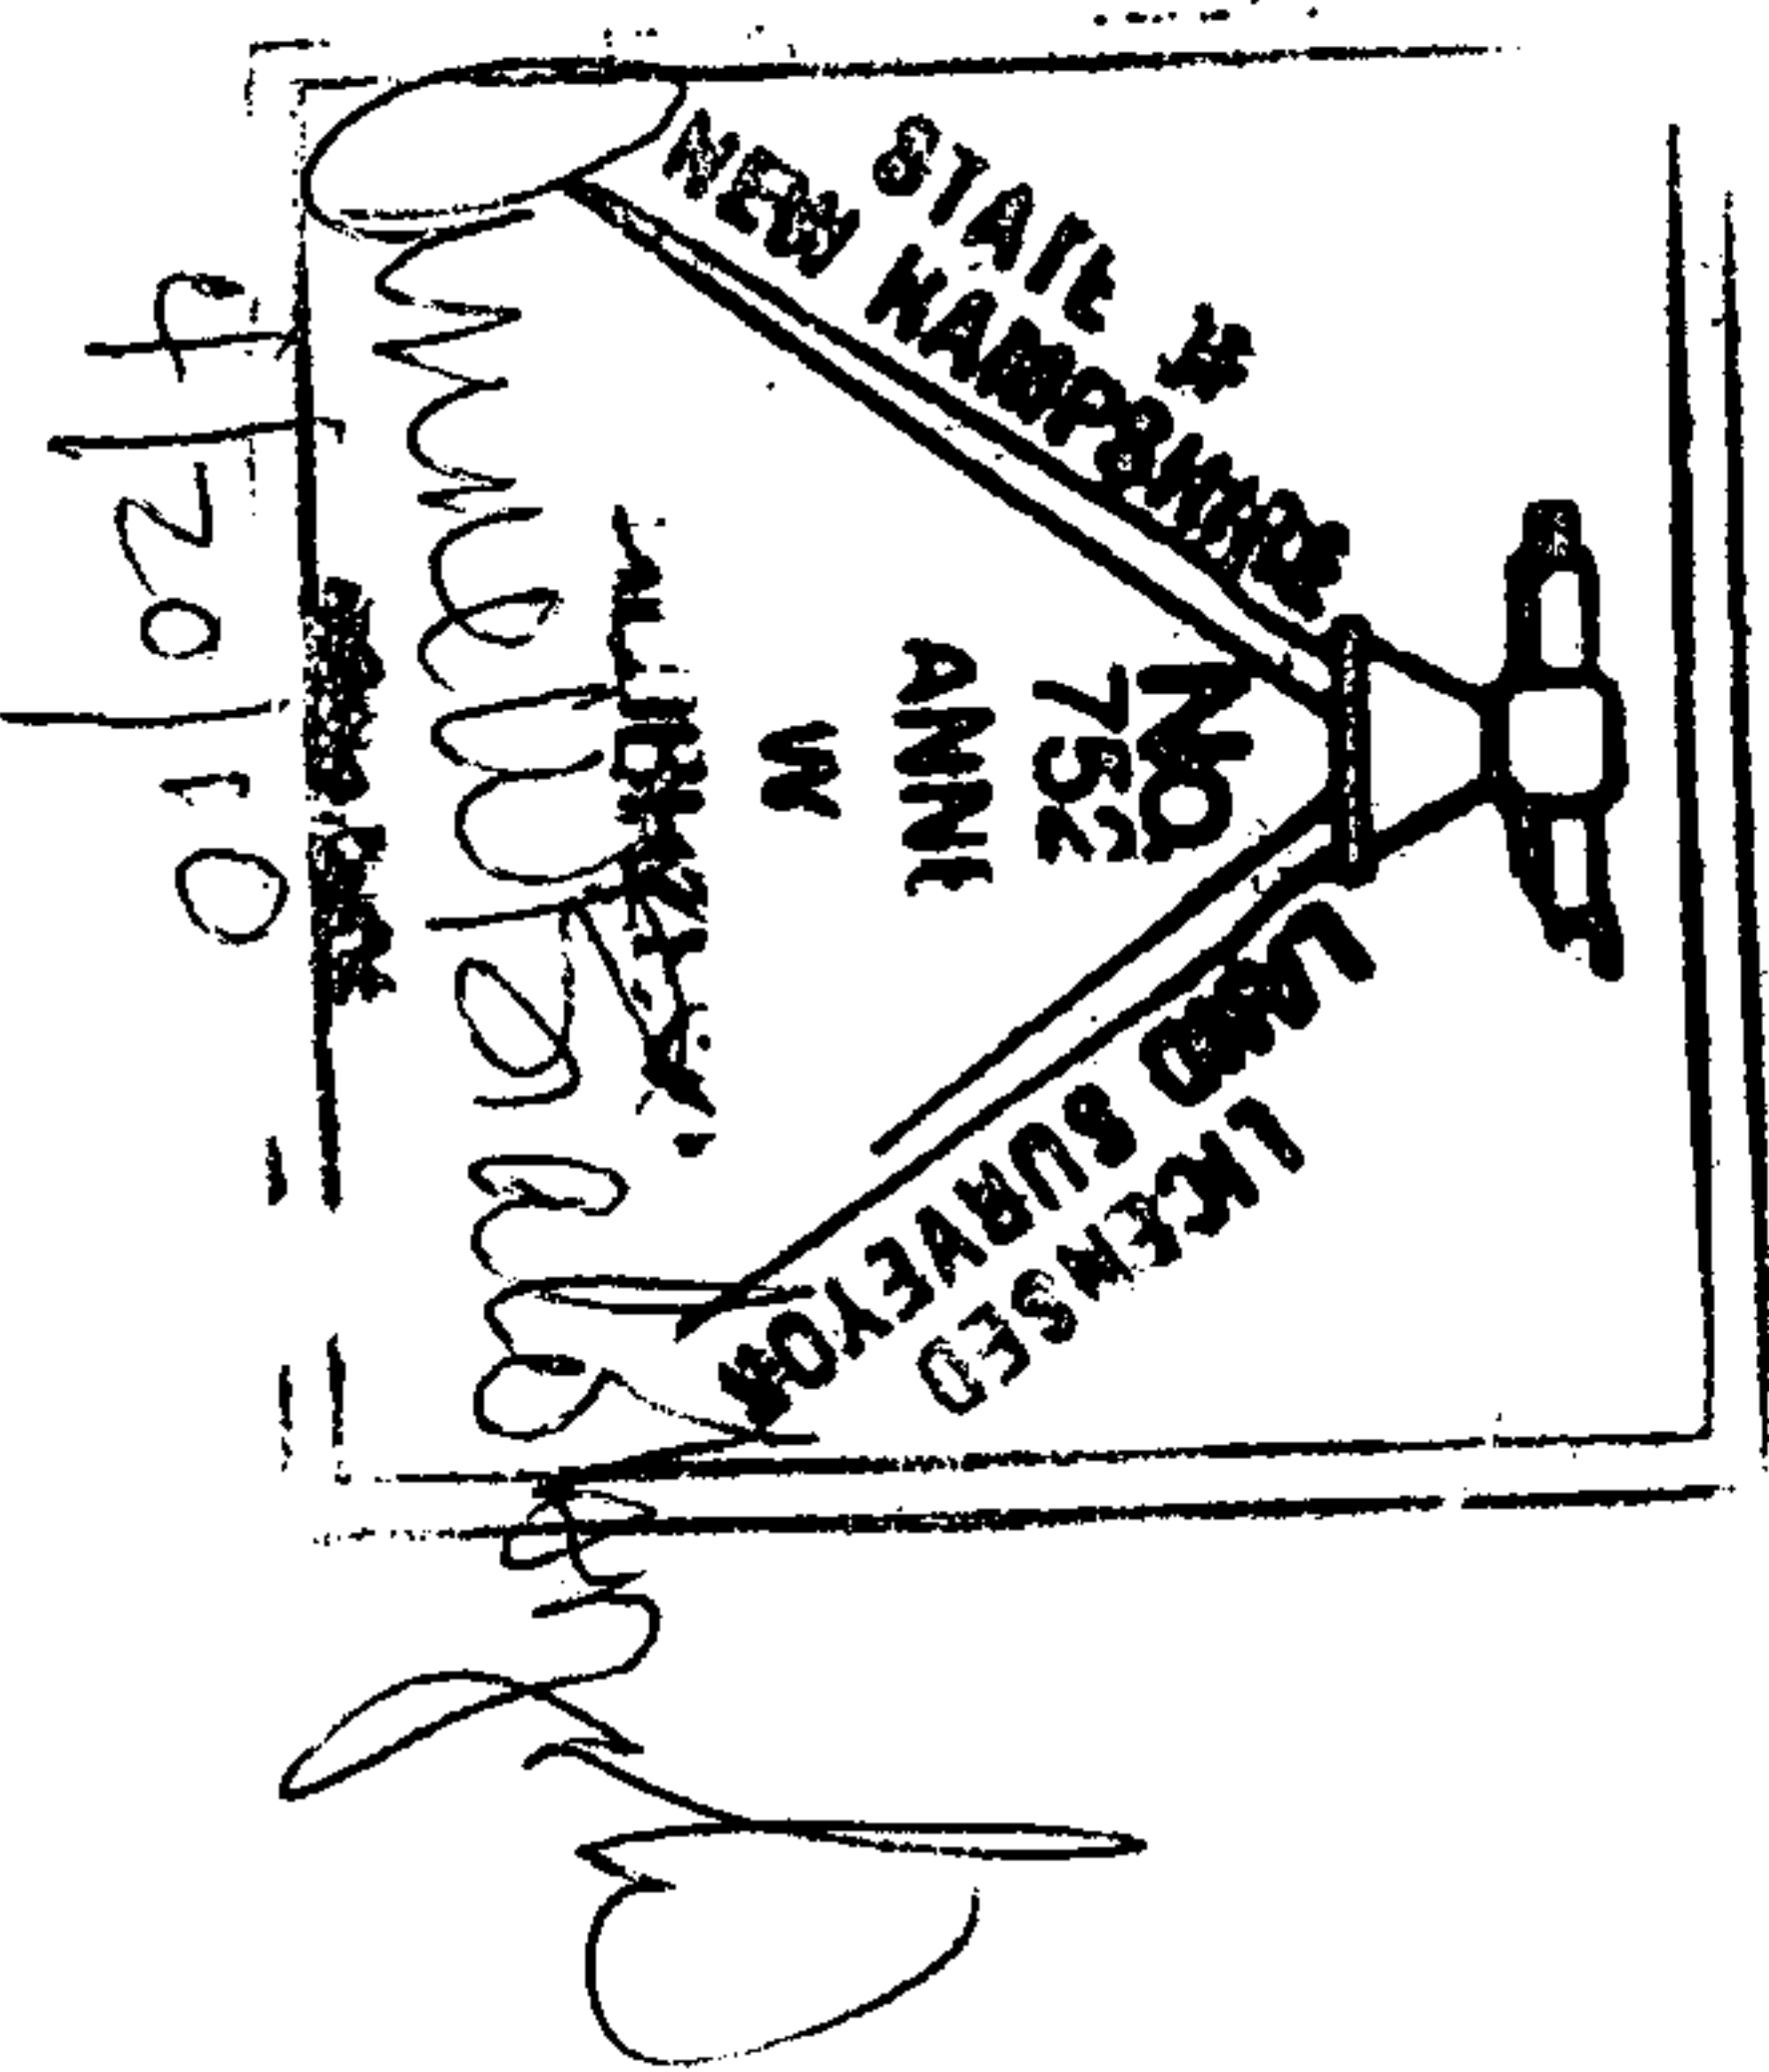

THE PURPOSE OF THIS PLAN IS TO SHOW  
PROPOSED BUILDING AND SETBACKS FOR  
BUILDING PERMIT APPLICATION ONLY.  
NO OTHER REPRESENTATION IS INTENDED  
OR IMPLIED.

NOTE:  
BUILDING SETBACKS SHOWN  
ARE TO ROOF OVERHANG.

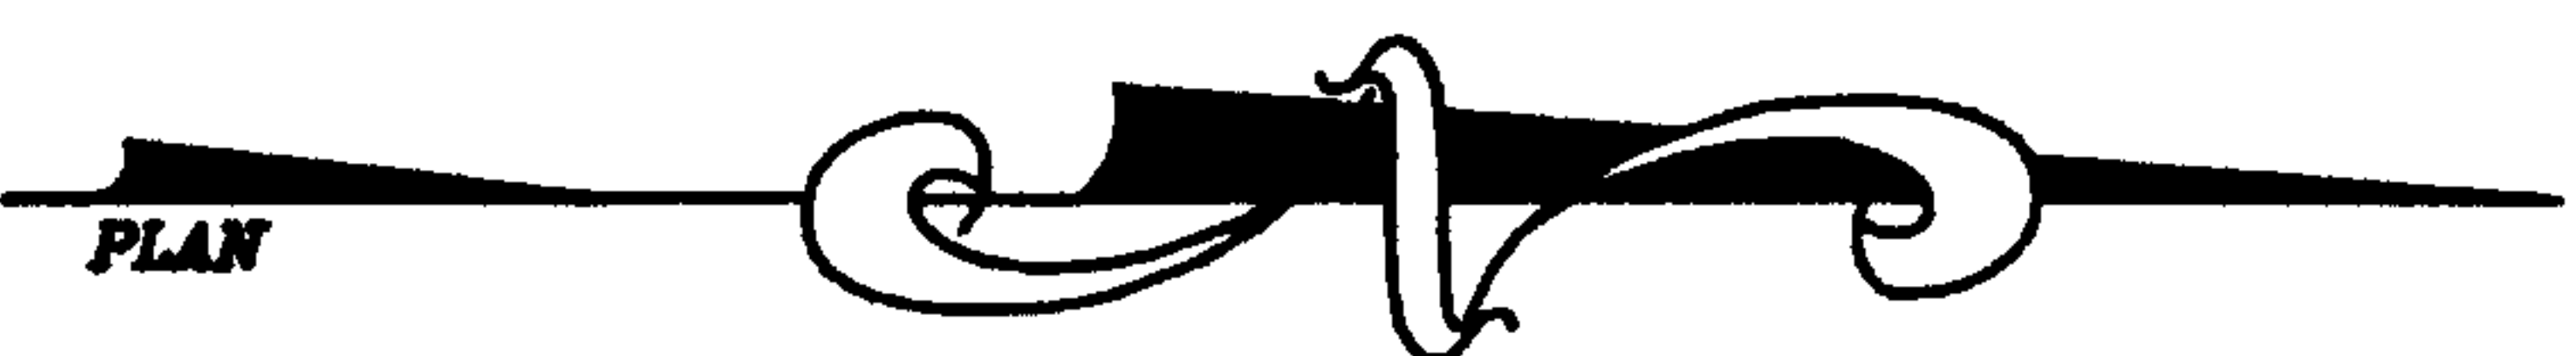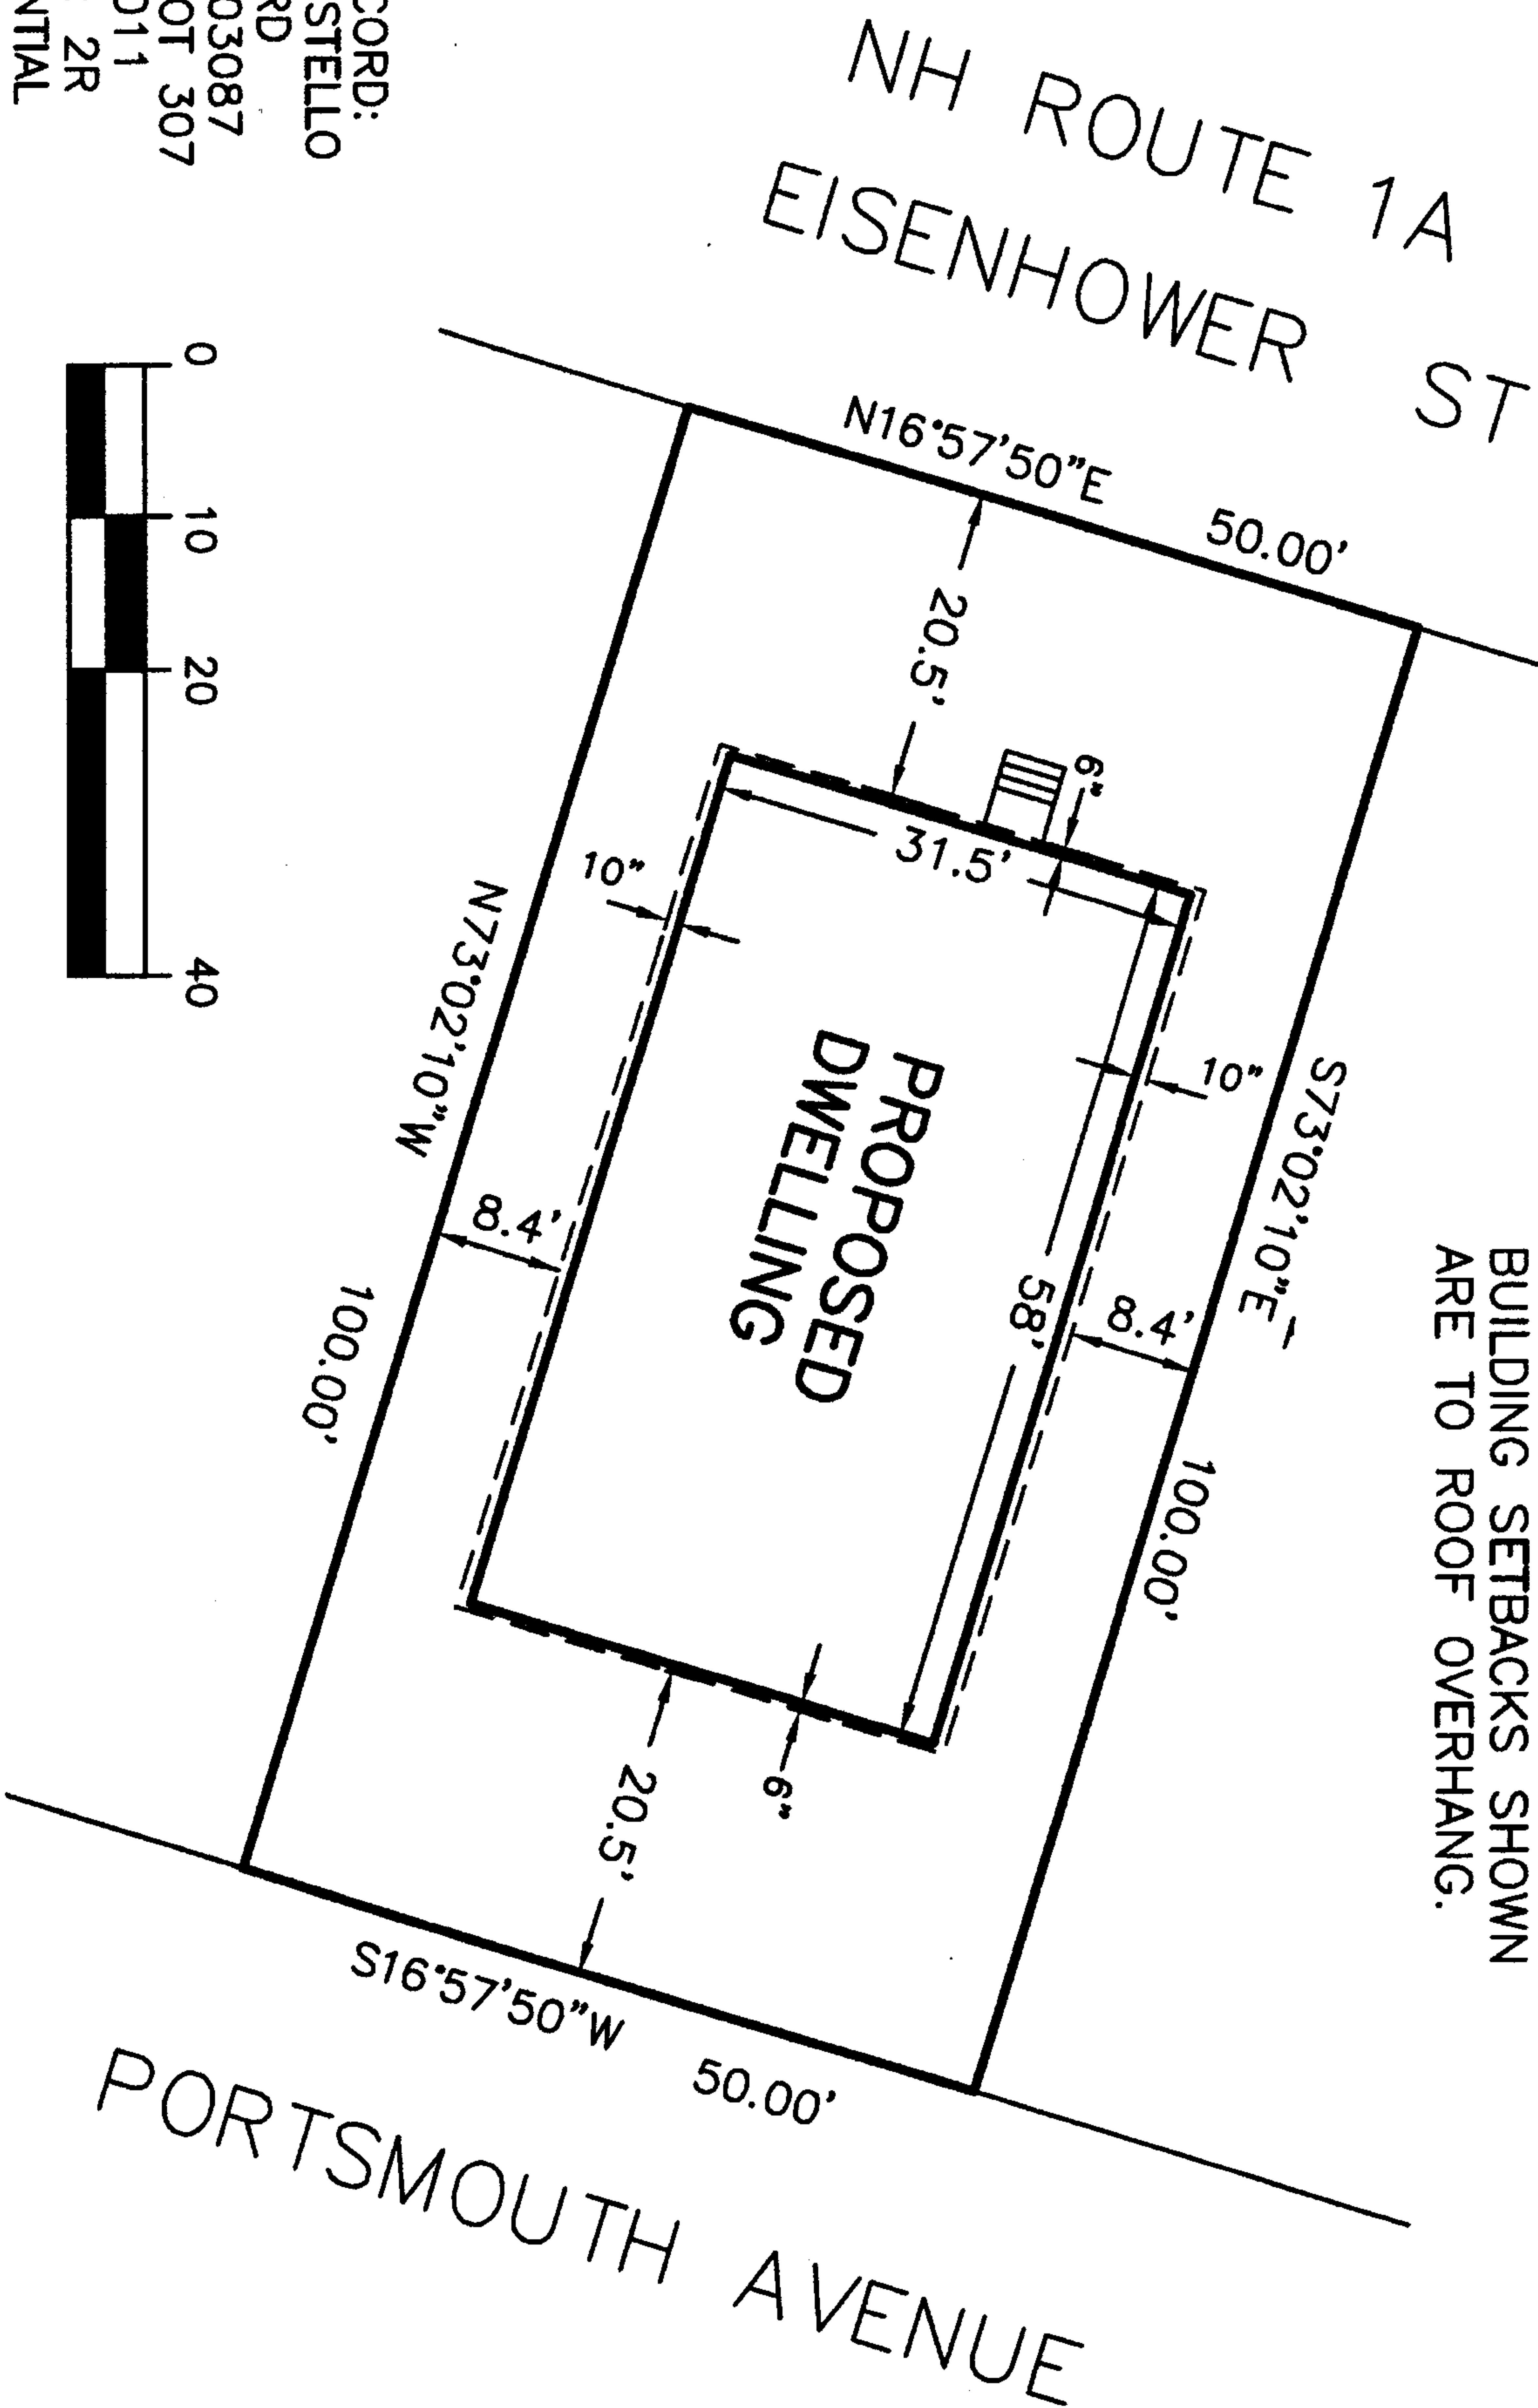



FOUNDATION CERTIFICATION PLAN  
LAND OF JANE BEAL-COSTELLO  
307 PORTSMOUTH AVENUE  
SEABROOK, NH

SCALE: 1"=20' MAY 27, 2010

STOCKTON SERVICES  
PO BOX 1306, HAMPTON, NH 03843-1306  
603 929-7404

THE PURPOSE OF THIS PLAN IS TO CERTIFY TO  
THE LOCATION OF FOUNDATION AS CONSTRUCTED.  
NO OTHER REPRESENTATION IS INTENDED OR IMPLIED.

OWNER OF RECORD:  
JANE BEAL-COSTELLO  
28 FARWOOD RD  
WINDHAM, NH 03087  
TAX MAP 20 LOT 307  
RCRD 4226-1011  
ZONING CLASS: 2R  
BEACH RESIDENTIAL

